


LIPPITT MILL

WEST WARWICK

RHODE ISLAND

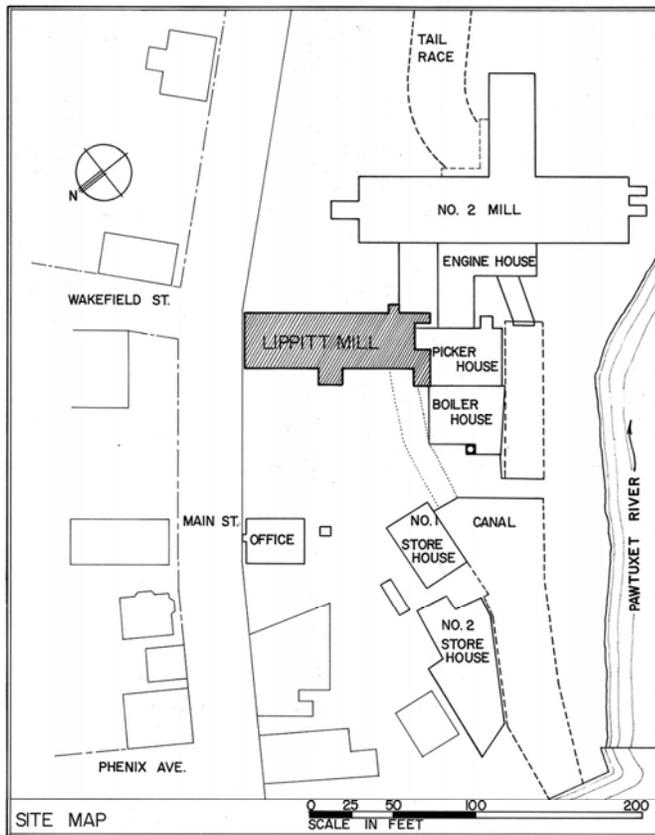

THE LIPPITT MILL HAS CONTINUOUSLY PRODUCED TEXTILES FROM ITS START AS A COTTON MILL IN 1810 TO ITS CURRENT MANUFACTURE OF LACE. IT IS ONE OF THE OLDEST WOODEN FRAME TEXTILE MILL BUILDING IN RHODE ISLAND AND IS REPRESENTATIVE OF THE ONCE NUMEROUS SMALL TEXTILE MILLS OF THE STATE.

THE NEW ENGLAND TEXTILE MILL SURVEY I

THIS BUILDING WAS RECORDED AS PART OF THE NEW ENGLAND TEXTILE MILL SURVEY I; WHICH WAS SPONSORED BY THE HISTORIC AMERICAN BUILDINGS SURVEY OF THE OFFICE OF ARCHEOLOGY AND HISTORIC PRESERVATION OF THE NATIONAL PARK SERVICE, THE SMITHSONIAN INSTITUTION, AND THE MERRIMACK VALLEY TEXTILE MUSEUM. THE PROJECT WAS ASSISTED BY THE MANCHESTER (NEW HAMPSHIRE) HISTORIC ASSOCIATION, THE MANCHESTER HOUSING AUTHORITY AND MR. FRANCIS C. WELCH, PRESIDENT OF THE ESSEX COMPANY OF LAWRENCE, MASSACHUSETTS.

THE FIELD WORK, HISTORIC RESEARCH AND RECORD DRAWINGS WERE DONE IN THE SUMMER OF 1967 UNDER THE DIRECTION OF ROBERT M. VOGEL (CURATOR OF MECHANICAL AND CIVIL ENGINEERING, MUSEUM OF HISTORY AND TECHNOLOGY, SMITHSONIAN INSTITUTION), PROJECT DIRECTOR; LARRY D. NICHOLS (ARCHITECT, CORNELL UNIVERSITY), PROJECT SUPERVISOR; RALSTON H. NAGATA (UNIVERSITY OF HAWAII), ARCHITECT; AND PHILLIP J. BLACK (UNIVERSITY OF OKLAHOMA), R RANDOLPH LANGENBACH (HARVARD UNIVERSITY), STUART E. MACDONALD (UNIVERSITY OF MINNESOTA) AND RAUL G. REYES (UNIVERSITY OF ARIZONA), STUDENT ASSISTANT ARCHITECTS.

DRAWN BY: DONALD G. PRYCE 1971

NEW ENGLAND TEXTILE MILL SURVEY I
OFFICE OF ARCHEOLOGY & HISTORIC PRESERVATION
UNDER DIRECTION OF THE NATIONAL PARK SERVICE
UNITED STATES DEPARTMENT OF THE INTERIOR

NAME AND LOCATION OF STRUCTURE

LIPPITT MILL

SURVEY NO.

RI-338

HISTORIC AMERICAN
BUILDINGS SURVEY
SHEET 1st OF 4 SHEETS


LIBRARY OF CONGRESS
INDEX NUMBER

825 MAIN STREET,

WEST WARWICK,

KENT COUNTY,


RHODE ISLAND

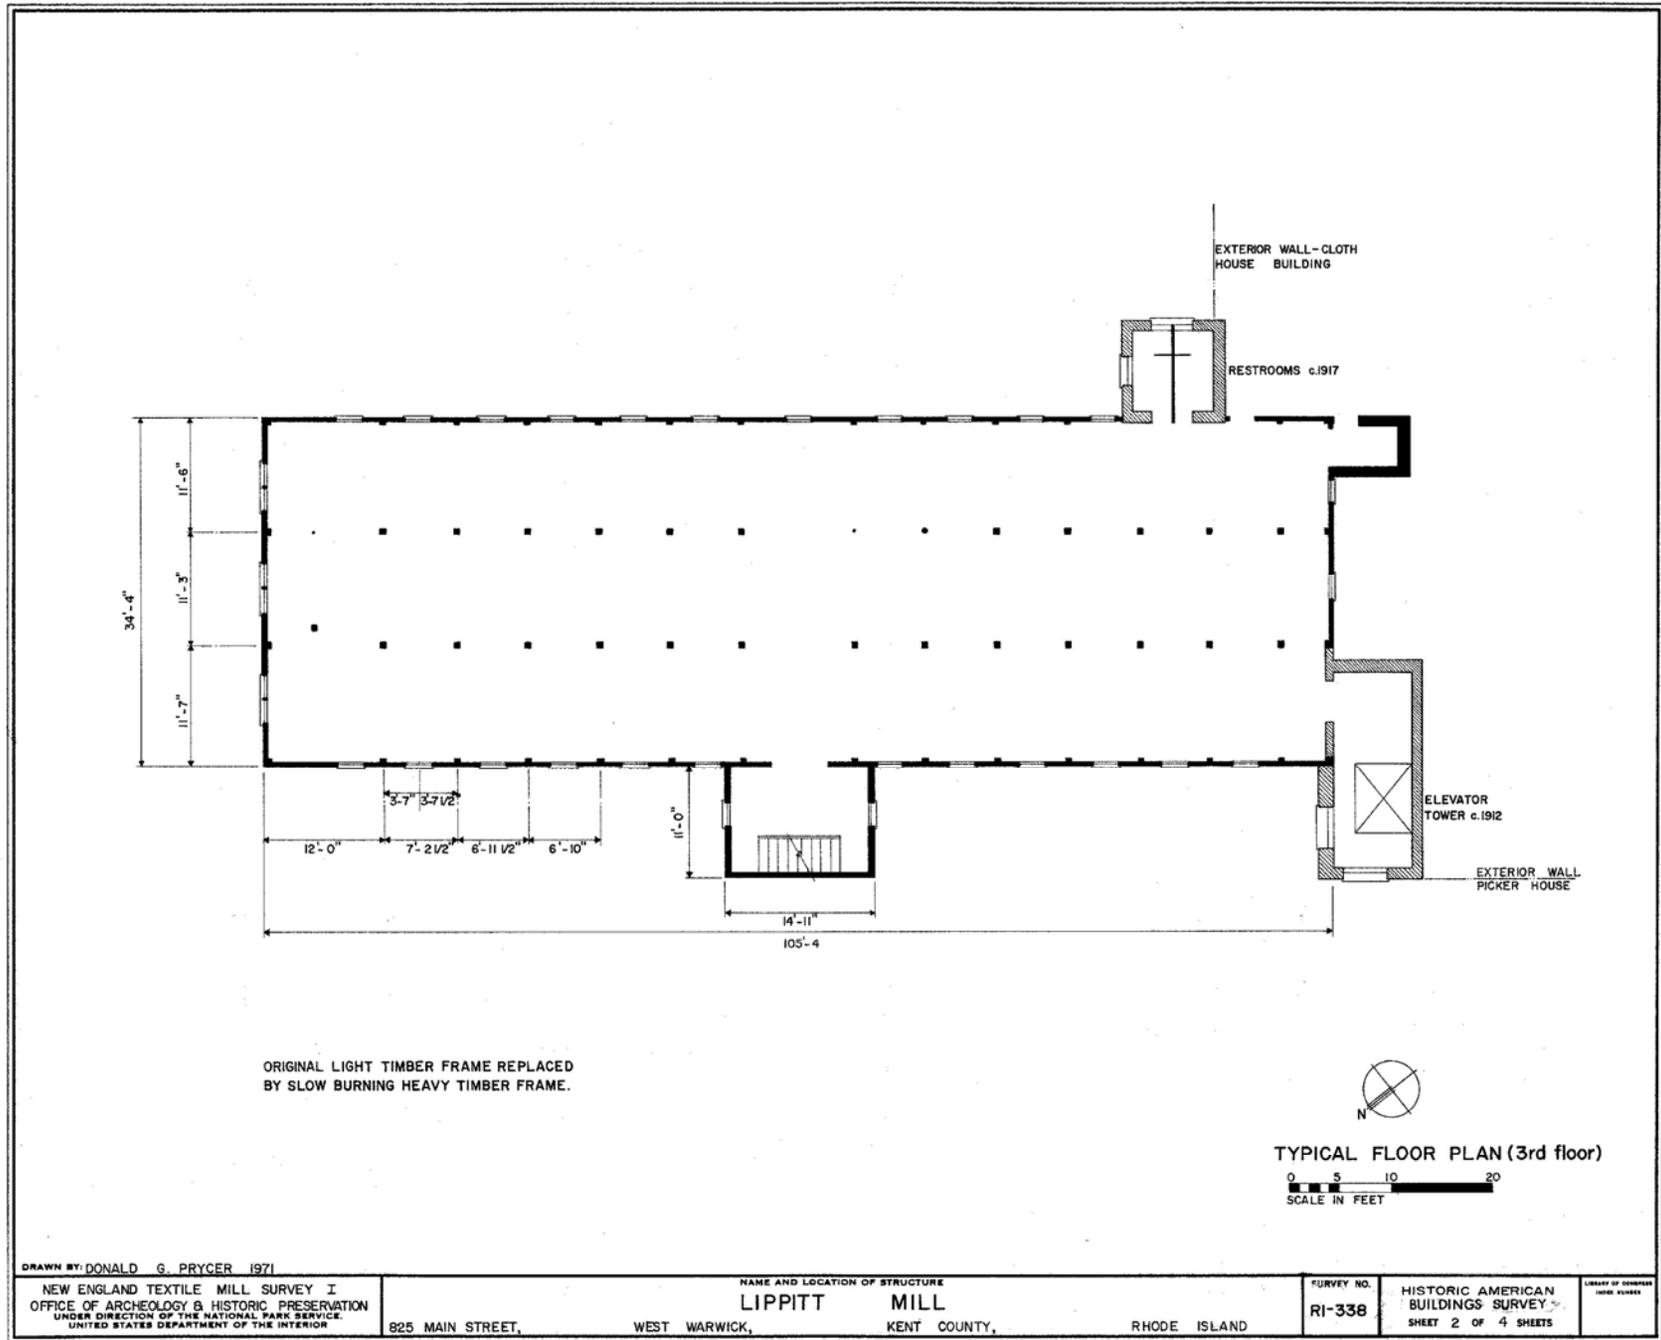

<http://www.loc.gov/pictures/item/ri0025.sheet.00003a/>

Library of Congress


www.loc.gov/teachers

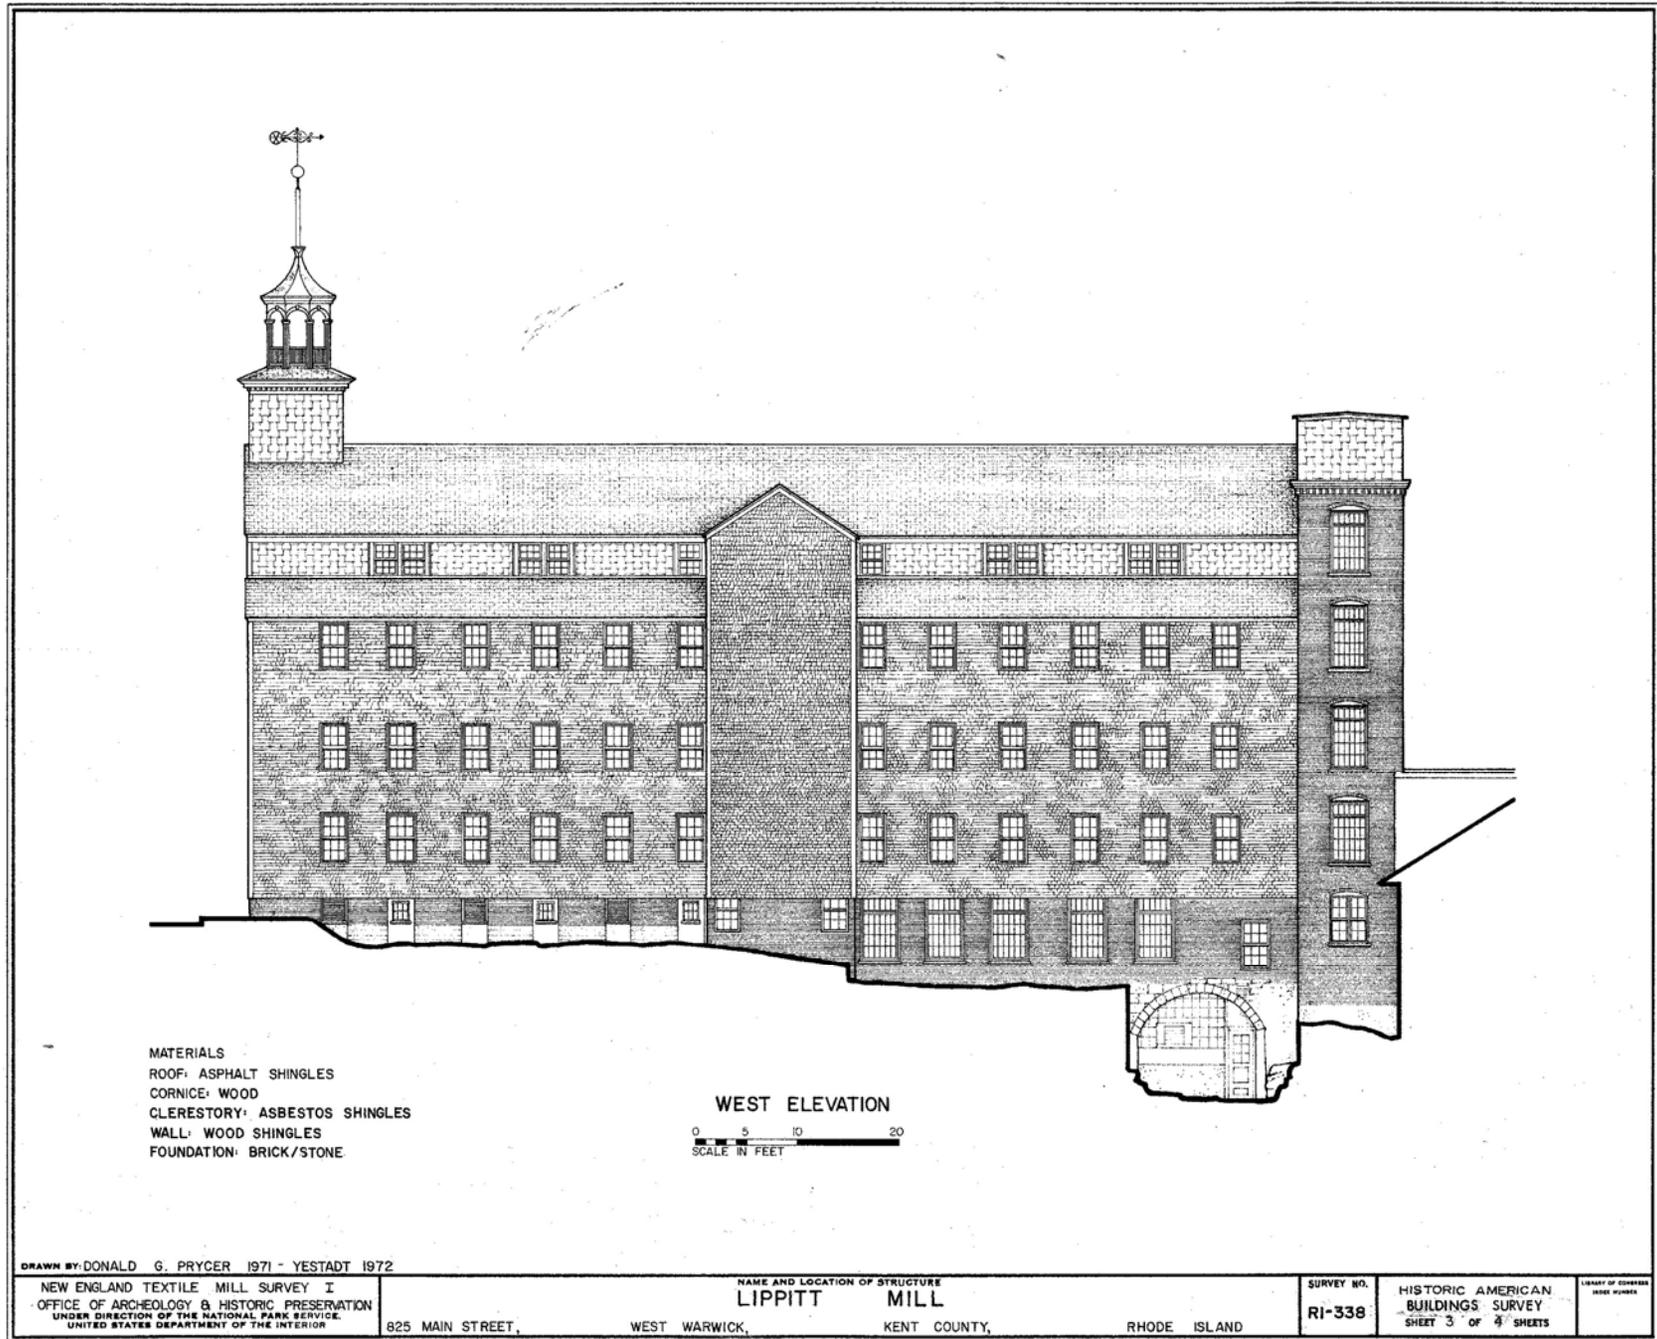


<http://www.loc.gov/pictures/item/ri0025.sheet.00003a/>

Library of Congress

www.loc.gov/teachers

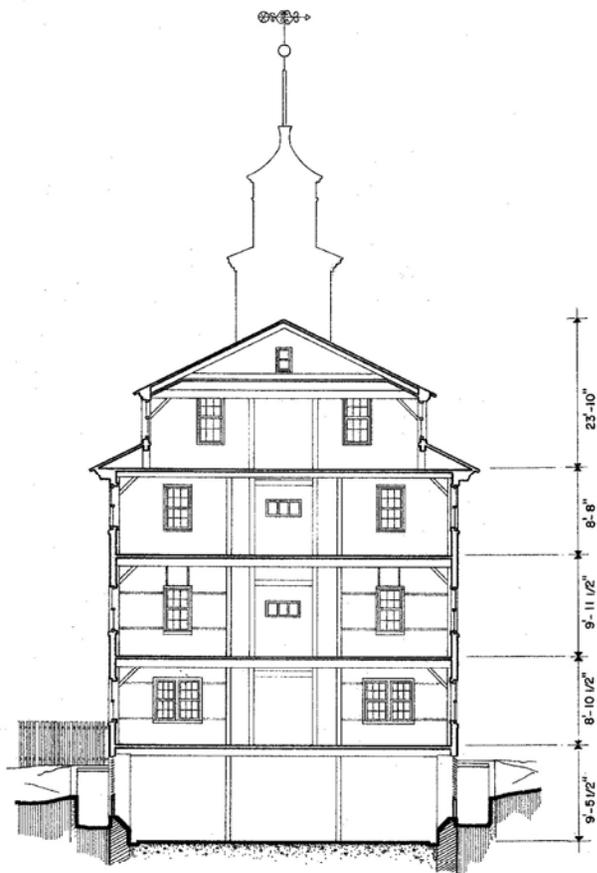

SECTION LOOKING NORTH

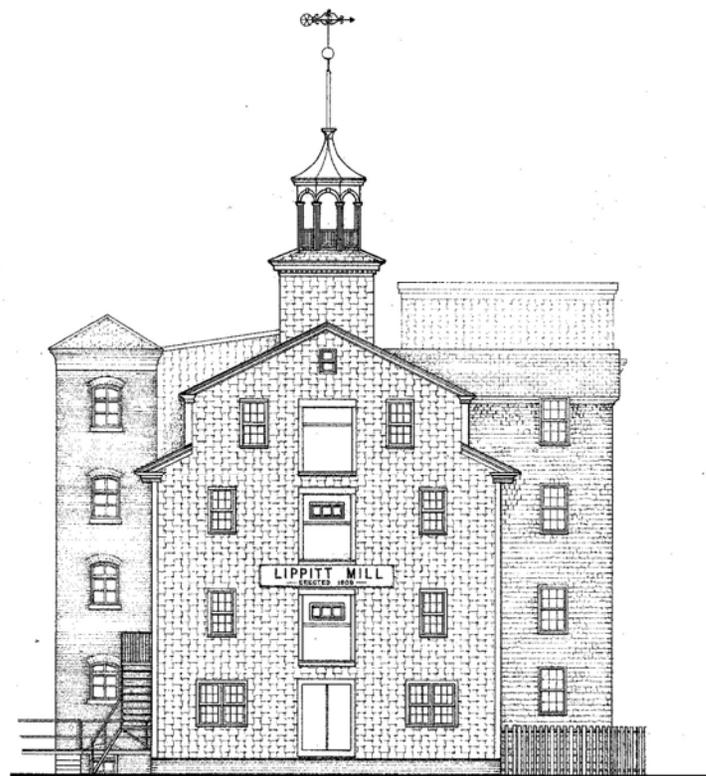

NORTH ELEVATION



DRAWN BY: DONALD G. PRYCE 1971 - YESTADT 1972

NEW ENGLAND TEXTILE MILL SURVEY I
 OFFICE OF ARCHEOLOGY & HISTORIC PRESERVATION
 UNDER DIRECTION OF THE NATIONAL PARK SERVICE
 UNITED STATES DEPARTMENT OF THE INTERIOR

NAME AND LOCATION OF STRUCTURE

LIPPITT MILL

825 MAIN STREET,

WEST WARWICK,

KENT COUNTY,

RHODE ISLAND

SURVEY NO.

RI-338

HISTORIC AMERICAN
 BUILDINGS SURVEY
 SHEET 4 OF 4 SHEETS

LIBRARY OF CONGRESS

TEXT NUMBER